

PUBLIC PATH DIVERSION ORDER

Highways Act 1980

Solihull Metropolitan Borough Council

PUBLIC FOOTPATH SL20A (PART), ARDEN ACADEMY, KNOWLE, SOLIHULL

This order is made by Solihull Metropolitan Borough Council (the **Council**) under section 119 of the Highways Act 1980 (the **1980 Act**) because it appears to the Council that in the interests of the lessee of the land crossed by the footpath described in paragraph 1 of this order it is expedient that the line of the path should be diverted.

The lessee has agreed to defray any compensation which becomes payable in consequence of the coming into operation of this order and any expenses which are incurred in bringing the new site of the path into a fit condition for use by the public.

Knowle Ward Members and Knowle Society have been consulted and Solihull Metropolitan Borough Council have consented to the making of this order as required by section 120(2) of the 1980 Act.

BY THIS ORDER:

- 1 The public right of way over the land situate at the northern edge of Arden Academy school site, Knowle and shown by a bold continuous line on the map contained in this order and described in Part 1 of the Schedule to this order shall be stopped up from date of confirmation of this order.
- 2 There shall be from the date of confirmation of this order be a public footpath over the land situate at the far northern edge of Arden Academy school site, Knowle described in Part 2 of the Schedule and shown by a bold broken line on the map contained in this order.
- 3 The rights conferred on the public under this order shall be subject to the limitations and conditions set out in Part 3 of the Schedule.

SCHEDULE

PART 1

DESCRIPTION OF SITE OF EXISTING PATH OR WAY

Leads from Point A (Grid Ref: SP 41794,27634) at the north eastern edge of Arden Academy, Knowle off Milverton Road and heads in a north westerly direction, skirting closely around various school buildings via Point B (Grid Ref: SP 41787,27638) and then via Point C (Grid Ref: SP 41786,27638) along a tarmac path and past another school building near Station Road (B4101) to Point D (Grid Ref: SP 41783, 27640), a short distance off Station Road. The part of this public footpath number: (SL20A) is 128 metres and a width defined as 1.8m on the Definitive Statement.

PART 2

DESCRIPTION OF SITE OF NEW PATH OR WAY

Leads from Point A (Grid Ref: SP 41794,27634) at the north eastern edge of Arden Academy, Knowle off Milverton Road and heads in a north westerly direction but close to the northern edge of the school boundary, firstly passing near some small service buildings before joining a new tarmac route to be created at Point E (Grid Ref: SP 41792,27636) and proceeding north westerly via Point F (Grid Ref: SP 41792,27637) and then via a 1.8m gap in fence at Point G (Grid Ref: SP 41790,27640) and onto Point H (Grid Ref: SP 41785,27643) all along the new tarmac path before turning in a south westerly direction parallel with Station Road (B4101) and re-joining the existing footpath at Point D (Grid Ref: SP 41783, 27640). The part of this public footpath number: (SL20A) is 131 metres in length with a width of 1.8m.

PART 3

LIMITATIONS AND CONDITIONS

None

DATED: 28th July 2021


THE COMMON SEAL of THE)
METROPOLITAN BOROUGH OF SOLIHULL)
Was hereunto affixed in the presence of:-)
)



[Handwritten Signature]

SOLICITOR TO THE COUNCIL

The foregoing order is hereby confirmed
subject to the red ink modifications thereon
Charlotte Ditchburn 15 DEC 2023
An Inspector appointed by The Secretary
of State for Environment, Food and
Rural Affairs

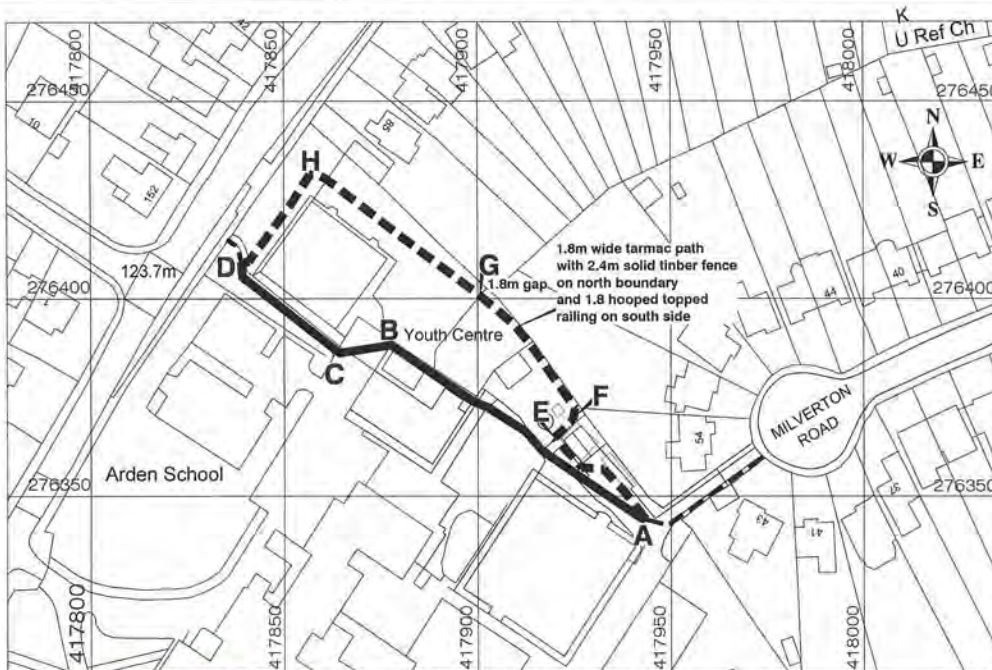

SCALE 1:1250 @ A4
 0 10 20 30 40 50 metres

KEY:

Section of Footpath to be Stopped Up

A B C D

Section of Footpath to be created

A E F G H D

Existing (unaffected) public footpaths

GRID REFERENCES:

- A = SP 417943 276344
- B = SP 417877 276388
- C = SP 417864 276386
- D = SP 417838 276408
- E = SP 417920 276364
- F = SP 417925 276372
- G = SP 417900 276400
- H = SP 417858 276431

A-B-C-D = 128 metres
 A-E-F-G-H-D = 131 metres

© Crown copyright and database rights 2021 Ordnance Survey 0100031673



SOLIHULL METROPOLITAN BOROUGH COUNCIL
 HIGHWAYS ACT 1980 S.119
 Proposed Diversion of Public Footpath SL20A
 between
 Station Road and Milverton Road,
 Solihull 2021

